



BUILDING AND NEIGHBORHOOD COMPLIANCE DEPARTMENT (BNC)
BOARD AND CODE ADMINISTRATION DIVISION

MIAMI-DADE COUNTY
PRODUCT CONTROL SECTION
11805 SW 26 Street, Room 208
Miami, Florida 33175-2474
T (786) 315-2590 F (786) 315-2599

NOTICE OF ACCEPTANCE (NOA)

www.miamidade.gov/building/home/asp

Nan Ya Plastics Corporation, USA
8989 North Loop East, Suite 800
Houston, TX 77029

SCOPE:

This NOA is being issued under the applicable rules and regulations governing the use of construction materials. The documentation submitted has been reviewed and accepted by Miami-Dade County BNC -Product Control Section to be used in Miami Dade County and other areas where allowed by the Authority Having Jurisdiction (AHJ).

This NOA shall not be valid after the expiration date stated below. The Miami-Dade County Product Control Section (In Miami Dade County) and/or the AHJ (in areas other than Miami Dade County) reserve the right to have this product or material tested for quality assurance purposes. If this product or material fails to perform in the accepted manner, the manufacturer will incur the expense of such testing and the AHJ may immediately revoke, modify, or suspend the use of such product or material within their jurisdiction. BNC reserves the right to revoke this acceptance, if it is determined by Miami-Dade County Product Control Section that this product or material fails to meet the requirements of the applicable building code.

This product is approved as described herein, and has been designed to comply with the Florida Building Code, including the High Velocity Hurricane Zone.

DESCRIPTION: "Distinction" Series Fiberglass Sliding Glass Door – L.M.I.

APPROVAL DOCUMENT: Drawing No. NAYT0001 Rev D, titled "8' Fiberglass Gliding Patio Door (OXO)", sheets 1 through 7 of 7, dated 08/25/05 and last revised on 07/25/11, prepared by PTC, LLC, signed and sealed by Robert James Amoruso, P.E., bearing the Miami-Dade County Product Control Revision stamp with the Notice of Acceptance number and expiration date by the Miami-Dade County Product Control Section.

MISSILE IMPACT RATING: Large and Small Missile Impact Resistant

LABELING: Each unit shall bear a permanent label with the manufacturer's name or logo, city, state and series and following statement: "Miami-Dade County Product Control Approved", unless otherwise noted herein.

RENEWAL of this NOA shall be considered after a renewal application has been filed and there has been no change in the applicable building code negatively affecting the performance of this product.

TERMINATION of this NOA will occur after the expiration date or if there has been a revision or change in the materials, use, and/or manufacture of the product or process. Misuse of this NOA as an endorsement of any product, for sales, advertising or any other purposes shall automatically terminate this NOA. Failure to comply with any section of this NOA shall be cause for termination and removal of NOA.

ADVERTISEMENT: The NOA number preceded by the words Miami-Dade County, Florida, and followed by the expiration date may be displayed in advertising literature. If any portion of the NOA is displayed, then it shall be done in its entirety.

INSPECTION: A copy of this entire NOA shall be provided to the user by the manufacturer or its distributors and shall be available for inspection at the job site at the request of the Building Official.

This NOA **revises & renews** NOA # 05-0921.10 and consists of this page 1 and evidence pages E-1 & E2, as well as approval document mentioned above.

The submitted documentation was reviewed by **Ishaq I. Chanda, P.E.**

MIAMI-DADE COUNTY
APPROVED

NOA No 11-0415.04
Expiration Date: August 03, 2016
Approval Date: September 29, 2011
Page 1

9/22/11

NOTICE OF ACCEPTANCE: EVIDENCE SUBMITTED

A. DRAWINGS (transferred from file # 05-0921.10)

1. Manufacturer's die drawings and sections.
2. Drawing No. **NAYT0001 Rev D**, titled "8'Fiberglass Gliding Patio Door(OXO)", sheets 1 through 7 of 7, dated 08/25/05 and last revised on 07/25/11, prepared by PTC, LLC, signed and sealed by Robert James Amoruso, P.E.

B. TESTS (transferred from file # 05-0921.10)

1. Test reports on: 1) Air Infiltration Test, per FBC, TAS 202-94
2) Uniform Static Air Pressure Test, Loading per FBC TAS 202-94
3) Water Resistance Test, per FBC, TAS 202-94
4) Large Missile Impact Test per FBC, TAS 201-94
5) Cyclic Wind Pressure Loading per FBC, TAS 203-94
6) Forced Entry Test, per FBC 2411 3.2.1, TAS 202-94

along with marked-up drawings and installation diagram of Distinction Series Fiberglass Gliding French door, prepared by ETC Laboratories, Test Report No. **ETC-05-255-16352.0**, dated 07/25/05, signed and sealed by Mark D. Passero, P.E.

C. CALCULATIONS


1. Anchor verification calculations, complying with FBC-2007, prepared by PTC, LLC, dated 02/28/11 and last revised on 07/25/11, signed and sealed by Robert James Amoruso, P.E.
2. Glazing complies w/ ASTM E-1300-02 & -04

D. QUALITY ASSURANCE

1. Miami Dade Building and Neighborhood Compliance Department (BNC).

E. MATERIAL CERTIFICATIONS

1. Notice of Acceptance No. 06-0216.06 issued to Solutia Inc. for "Interlayer for laminated glass", expiring on 03/04/14.
2. Test report No.ETC-05-255-16776.1, prepared by ETC Laboratories, dated 07/06/06, issued to Nan Ya Plastics Corp., for their SMC Fiberglass material / ETC05033 per ASTM D-638-03 "4500 exposed Xenon Arch" & tensile strength ASTM D-638-03 "Tensile strength", Smoke density per ASTM D2843-99, Rate of burning per ASTM D-635-98 and "Self ignition" per ASTM D1929-01, all signed and sealed by Joseph Labora Doldan, P.E.
3. Test report No.ETC-05-255-17144.0, prepared by ETC Laboratories, dated 07/03/08, issued to Nan Ya Plastics Corp., for their Rigid PVC plastic(part #ETC06024) per ASTM D1929-96 "Standard Test Method for Ignition Properties of Plastics", ASTM D2843-99 "Standard Test Method for Density of Smoke from the Burning or Decomposition of Plastics", ASTM D635-98 "Standard Test Method for Rate of Burning and/or Extent and Time of Burning of Self-Supporting Plastics in a Horizontal Position" and ASTM D638-03 "Standard Test Methods for Tensile Properties of Plastics" for exposed & unexposed sample per Xenon Arch after 4500 Hours, signed and sealed by Joseph Labora Doldan, P.E.

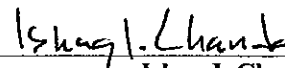

Ishaq I. Chanda, P.E.

Product Control Examiner

NOA No 11-0415.04

Expiration Date: August 03, 2016

Approval Date: September 29, 2011

NOTICE OF ACCEPTANCE: EVIDENCE SUBMITTED

F. MATERIAL CERTIFICATIONS (continue)


4. Test reports No(s).**ETC-06-255-17412.0**, prepared by ETC Laboratories, dated 04/25/06, issued to Nan Ya Plastics Corp., for their **Phenolic Foam Board / ETC06013** plastic per ASTM-E84-05 "*Standard Test Method for Surface Burning Characteristics of Building Materials*", Test report No.**ETC-05-255-17900.0**, dated 06/28/06, ETC06013 plastic per **ASTM D1929-96** "*Standard Test Method for Ignition Properties of Plastics*", both signed & sealed by Joseph Labora Doldan, P.E.
5. Test report No.**ETC-05-255-16777.1**, prepared by ETC Laboratories, dated 04/26/06, issued to Nan Ya Plastics Corp., for their **Cellular PVC / ETC05034** plastic per **ASTM D1929-96** "*Standard Test Method for Ignition Properties of Plastics*", **ASTM D2843-99** "*Standard Test Method for Density of Smoke from the Burning or Decomposition of Plastics*", **ASTM D635-98** "*Standard Test Method for Rate of Burning and/or Extent and Time of Burning of Self-Supporting Plastics in a Horizontal Position*" and **ASTM D638-03** "*Standard Test Methods for Tensile Properties of Plastics*", signed and sealed by Joseph Labora Doldan, P.E.
6. Statement letter dated September 21, 2011, for standard equivalency of ASTM E84-05 and ASTM D635-98 conforming to FBC 2007 for above referenced test reports, issued by PTC, LLC, signed & sealed by Robert J. Amoruso, P.E.

G. STATEMENTS

1. Statement letter of conformance and letter of no financial interest, prepared by PTC, LLC, dated 04/11/11, signed and sealed by Robert J. Amoruso, P.E.
2. Statement of lab compliance, as a part of above test report.


H. OTHER

1. This NOA **revises & renews** NOA # **05-0921.10**, expired on August 03, 2011.



Ishaq I. Chanda, P.E.
Product Control Examiner
NOA No 11-0415.04

Expiration Date: August 03, 2016
Approval Date: September 29, 2011

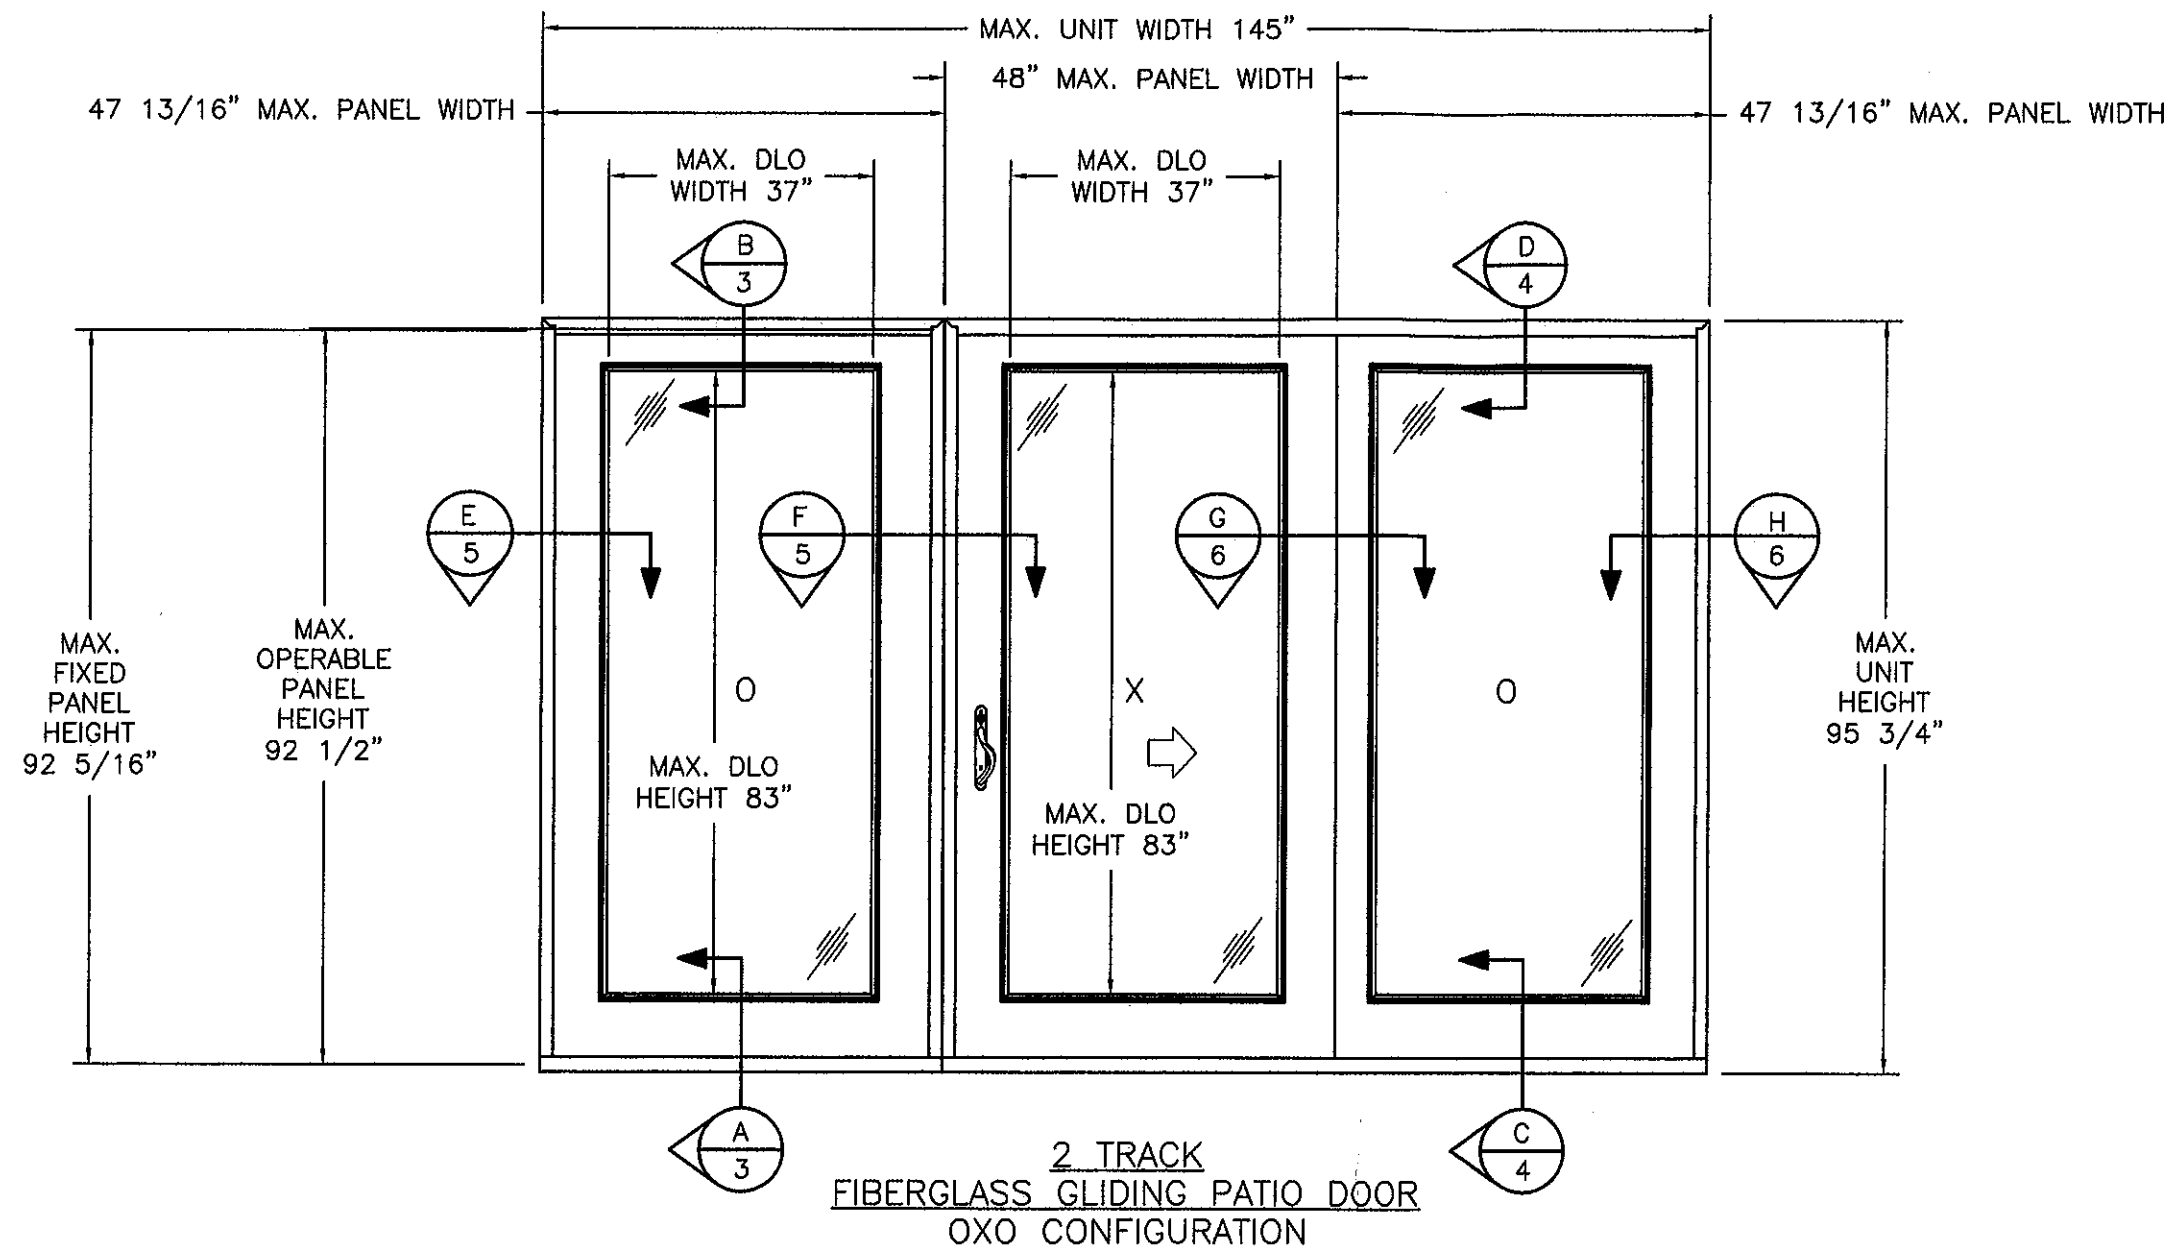

NOTE:

1. THE PRODUCT SHOWN HEREIN IS DESIGNATED AND MANUFACTURED TO COMPLY WITH THE 2007 FLORIDA BUILDING CODE INCLUDING THE HIGH VELOCITY HURRICANE ZONE (HVHZ).
2. 1X BUCK, 2X BUCK AND MASONRY OPENING TO BE DESIGNED AND ANCHORED TO PROPERLY TRANSFER ALL LOADS TO STRUCTURE. 2X BUCK AND MASONRY OPENING IS THE RESPONSIBILITY OF THE ARCHITECT OR ENGINEER OF RECORD.
3. APPROVED IMPACT PROTECTIVE SYSTEM IS NOT REQUIRED ON THIS PRODUCT.
4. SHIM AS REQUIRED AT EACH INSTALLATION ANCHOR WITH LOAD BEARING SHIM. SHIM WHERE SPACE OF 1/16" OR GREATER OCCURS, MAXIMUM TOTAL ALLOWABLE SHIM STACK 1/4".
5. USE SILICONE SEALANT FOR PERIMETER SEAL AROUND EXTERIOR OF DOORS.
6. DOOR FRAME AND DOOR PANEL MATERIAL: CELLULAR PVC, RIGID PVC AND SMC FIBERGLASS SKIN.
7. DOOR UNIT IS GLAZED ; 1.00" O.A. IGU CONSISTING OF 3/16" TEMPERED (EXTERIOR) GLASS; AIR SPACE; 3/16" ANNEALED GLASS; 0.090" PVB INTERLAYER AND 3/16" ANNEALED GLASS (INTERIOR).
8. SEAL HEAD, SILL AND JAMB CORNERS WITH SMALL JOINT SEAM SEALER.
9. IN ACCORDANCE WITH THE 2007 FBC, SECTION 2411.3.3.3 WOOD SHALL HAVE BEEN PRESERVATIVE TREATED OR SHALL BE OF A DURABLE SPECIES AS DEFINED IN SECTION 2326.2.

D	PER DADE LETTER DATED MAY 17, 2011	07/08/11	TJH
C	UPDATE TO 2007 FBC	02/28/11	JM
B	PER DADE COUNTY LETTER DATED	08/20/08	DRL
SYM	REVISION	DATE	BY

PTC PRODUCT DESIGN
GROUP, LLC
PO BOX 520775
LONGWOOD, FL 32752
FBC CERTIFICATE OF
AUTHORIZATION NO. 25935


Robert J. Amoroso P.E.
PL No. 49752

NAN YA PLASTICS CORPORATION
8909 NORTH LOOP EAST, HOUSTON TX. 77029

TITLE: 8' FIBERGLASS GLIDING PATIO DOOR (OXO)
ELEVATION AND GENERAL NOTES

PREPARED BY: PTC PTC PRODUCT DESIGN GROUP, LLC Phone 321-690-1788 Fax 321-690-1789	DRN: DRL SCALE: N.T.S. REV: D	DATE: 08/29/05 DWG. NO: NAYT0001 SHEET: 1 OF 7
--	--	---

PRODUCT REVISED
in compliance with the Florida
Building Code
Amendment No. 11-04 IS-04
Registration Date AUG 03, 2016
[Signature]
Product Control

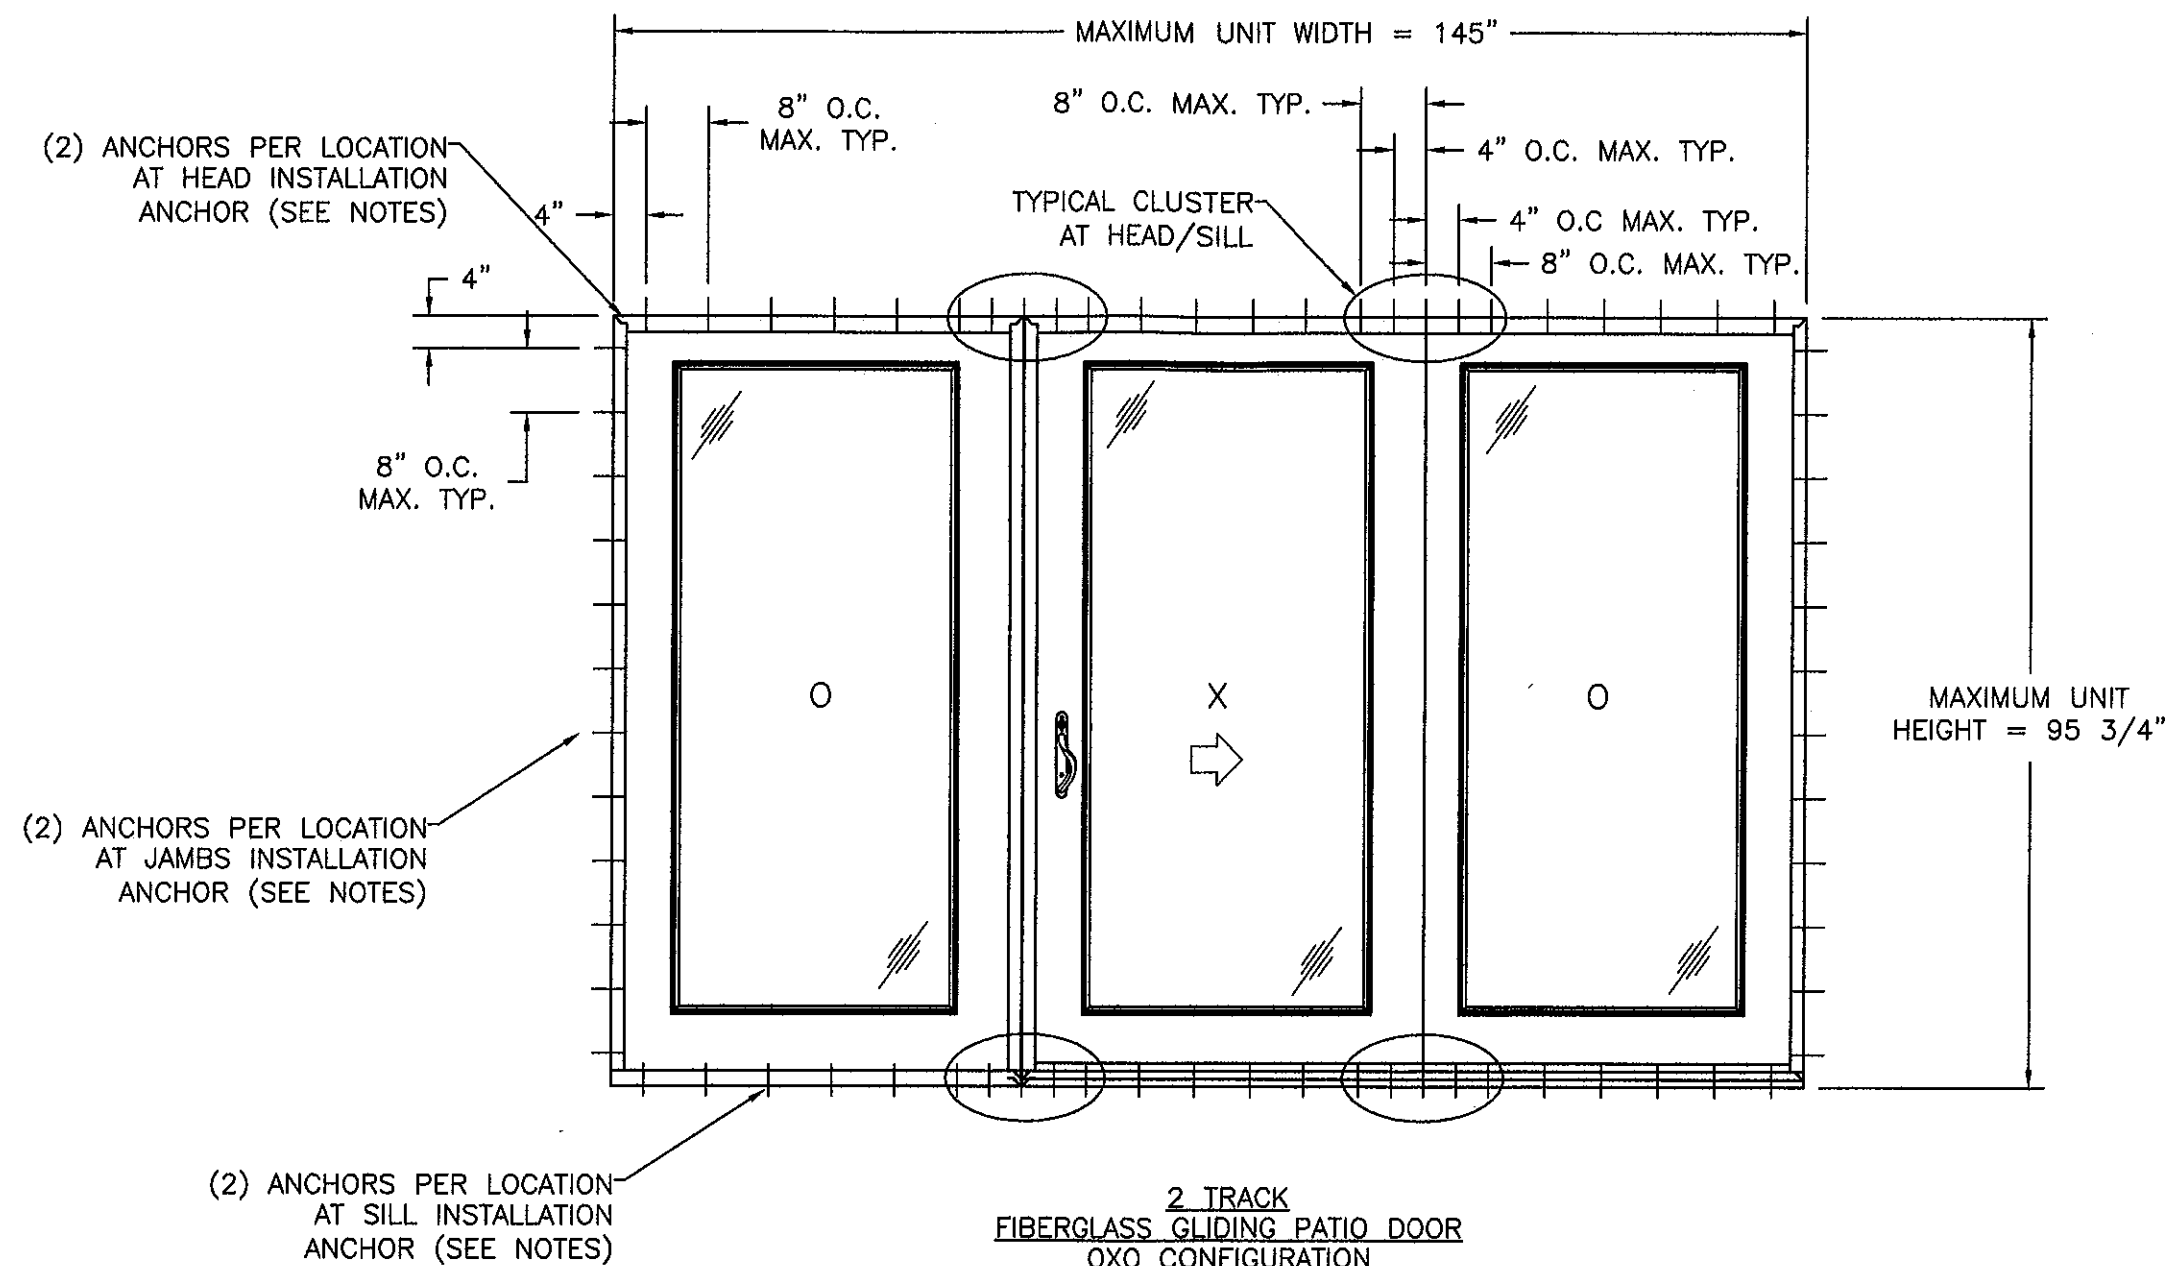

ANCHORING NOTES:

1. 3/16" DIAMETER I.T.W. (ADVANCED THREADFORM TECHNOLOGY) TAPCON MUST BE OF SUFFICIENT LENGTH TO ACHIEVE 1" MINIMUM EMBEDMENT INTO MASONRY AND 1 1/2" EMBEDMENT INTO CONCRETE. MINIMUM EDGE DISTANCE IS 2" IN MASONRY AND 1 1/8" IN CONCRETE. #12 WOOD SCREW MUST BE OF SUFFICIENT LENGTH TO ACHIEVE 1 1/2" MINIMUM EMBEDMENT INTO WOOD FRAMING W/ 7/8" MINIMUM EDGE DISTANCE.
2. ALL INSTALLATION ANCHORS MUST BE MADE OF CORROSIVE RESISTANT MATERIAL.
3. INSTALLATION ANCHOR CAPACITIES FOR PRODUCTS HEREIN ARE BASED ON SUBSTRATE MATERIALS WITH THE FOLLOWING PROPERTIES:
 - A. WOOD - P.T. SOUTHERN YELLOW PINE. MINIMUM SPECIFIC GRAVITY OF 0.55.
 - B. CONCRETE - MINIMUM COMPRESSIVE STRENGTH OF 2500 psi.
 - C. MASONRY (CMU or HOLLOW BLOCK) - STRENGTH CONFORMANCE TO ASTM C-90, MEDIUM WEIGHT/117 PCF DENSITY (OR GREATER)

PRODUCT REVISED
 as complying with the Florida
 Building Code
 Acceptance No. 11-0415.04
 Expiration Date AUG 23, 2016
 Shahid Chaudhary
 Head of Product Control

SYM	REVISION	DATE	BY
D	PER DADE LETTER DATED MAY 17, 2011	07/08/11	TJH
C	UPDATE TO 2007 FBC	02/28/11	JM
B	PER DADE COUNTY LETTER DATED	06/20/06	DRL



PTC PRODUCT DESIGN
 GROUP, LLC
 PO BOX 520775
 LONGWOOD, FL 32752
 FBPE CERTIFICATE OF
 AUTHORIZATION NO. 25935

Robert J. Amoruso, P.E.
 FL No. 49752

NAN YA PLASTICS CORPORATION
 8909 NORTH LOOP EAST, HOUSTON TX. 77029

TITLE: 8' FIBERGLASS GLIDING PATIO DOOR (OXO)
 ANCHORING AND NOTES

PREPARED BY: PTC PTC PRODUCT DESIGN GROUP, LLC Phone 321-690-1788 Fax 321-690-1789	DRN: DRL SCALE: N.T.S. REV: D	DATE: 08/29/05 DWG. NO: NAYT0001 SHEET: 2 OF 7
--	--	---

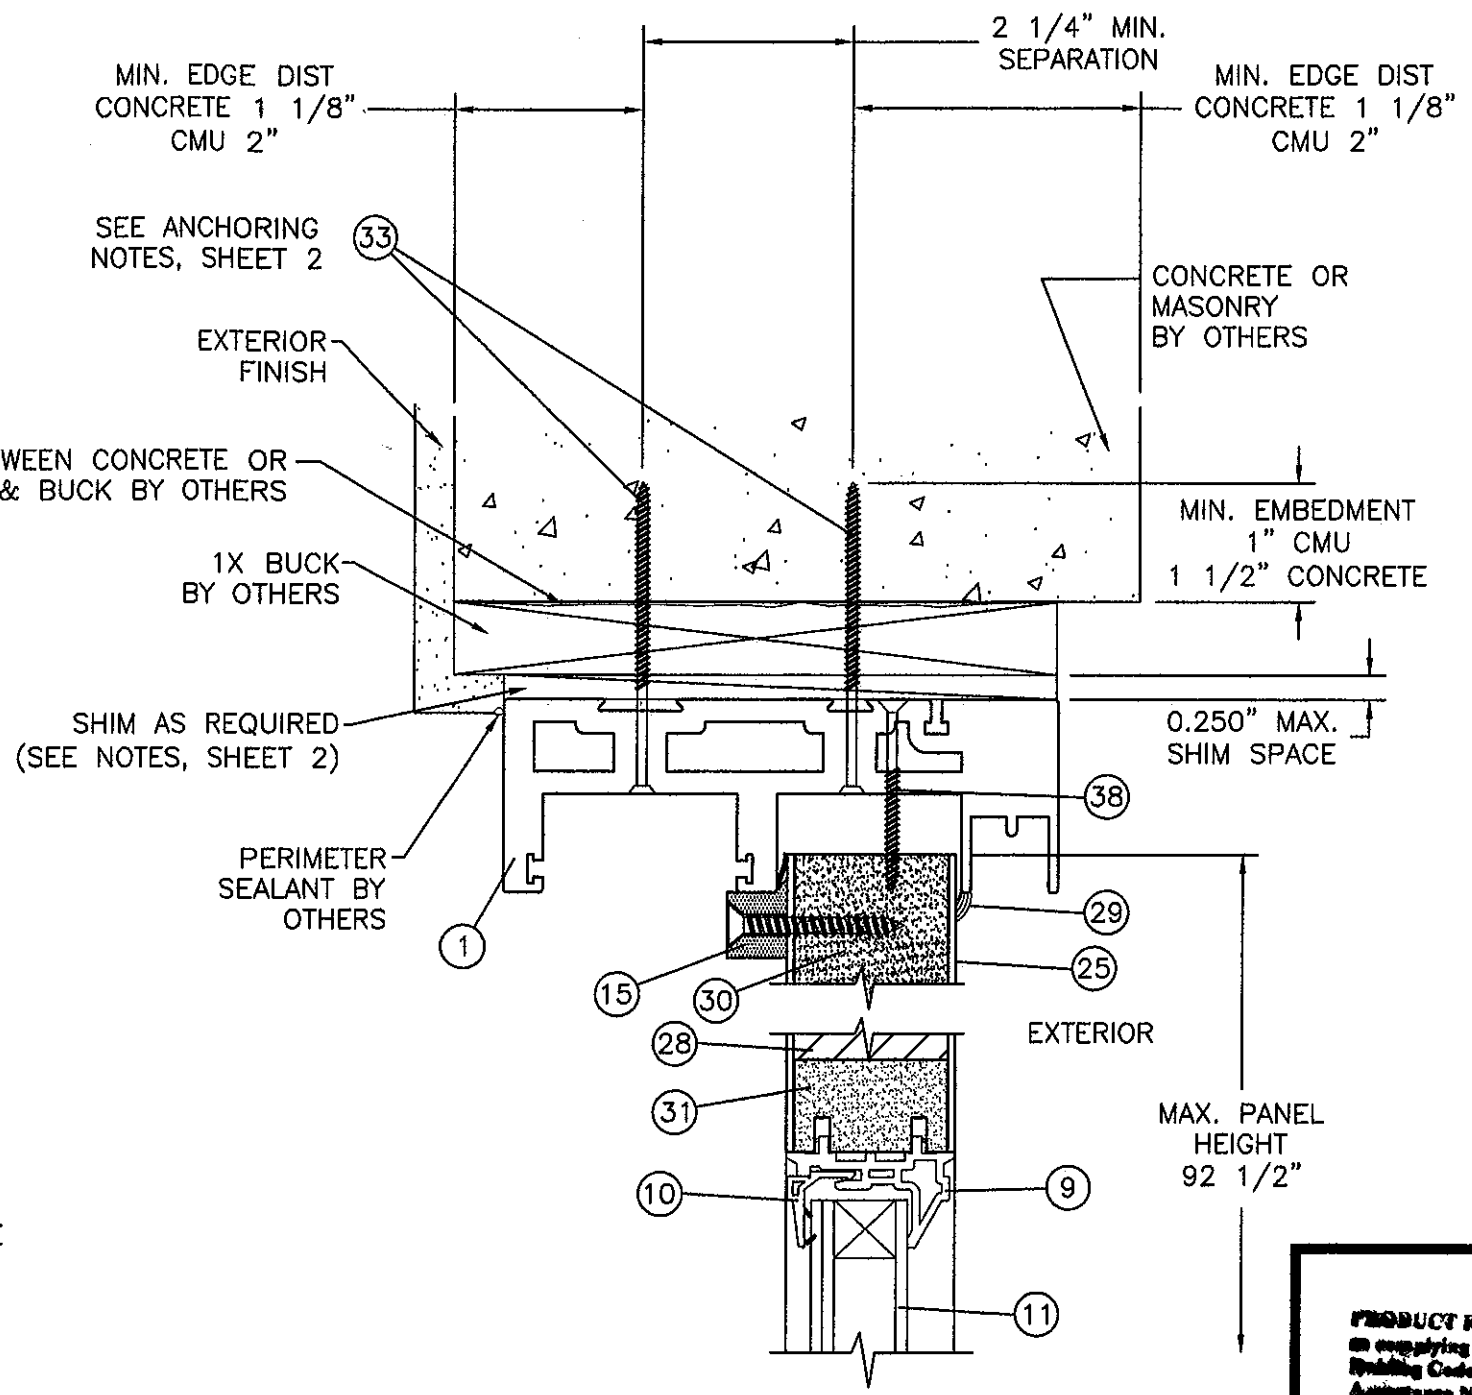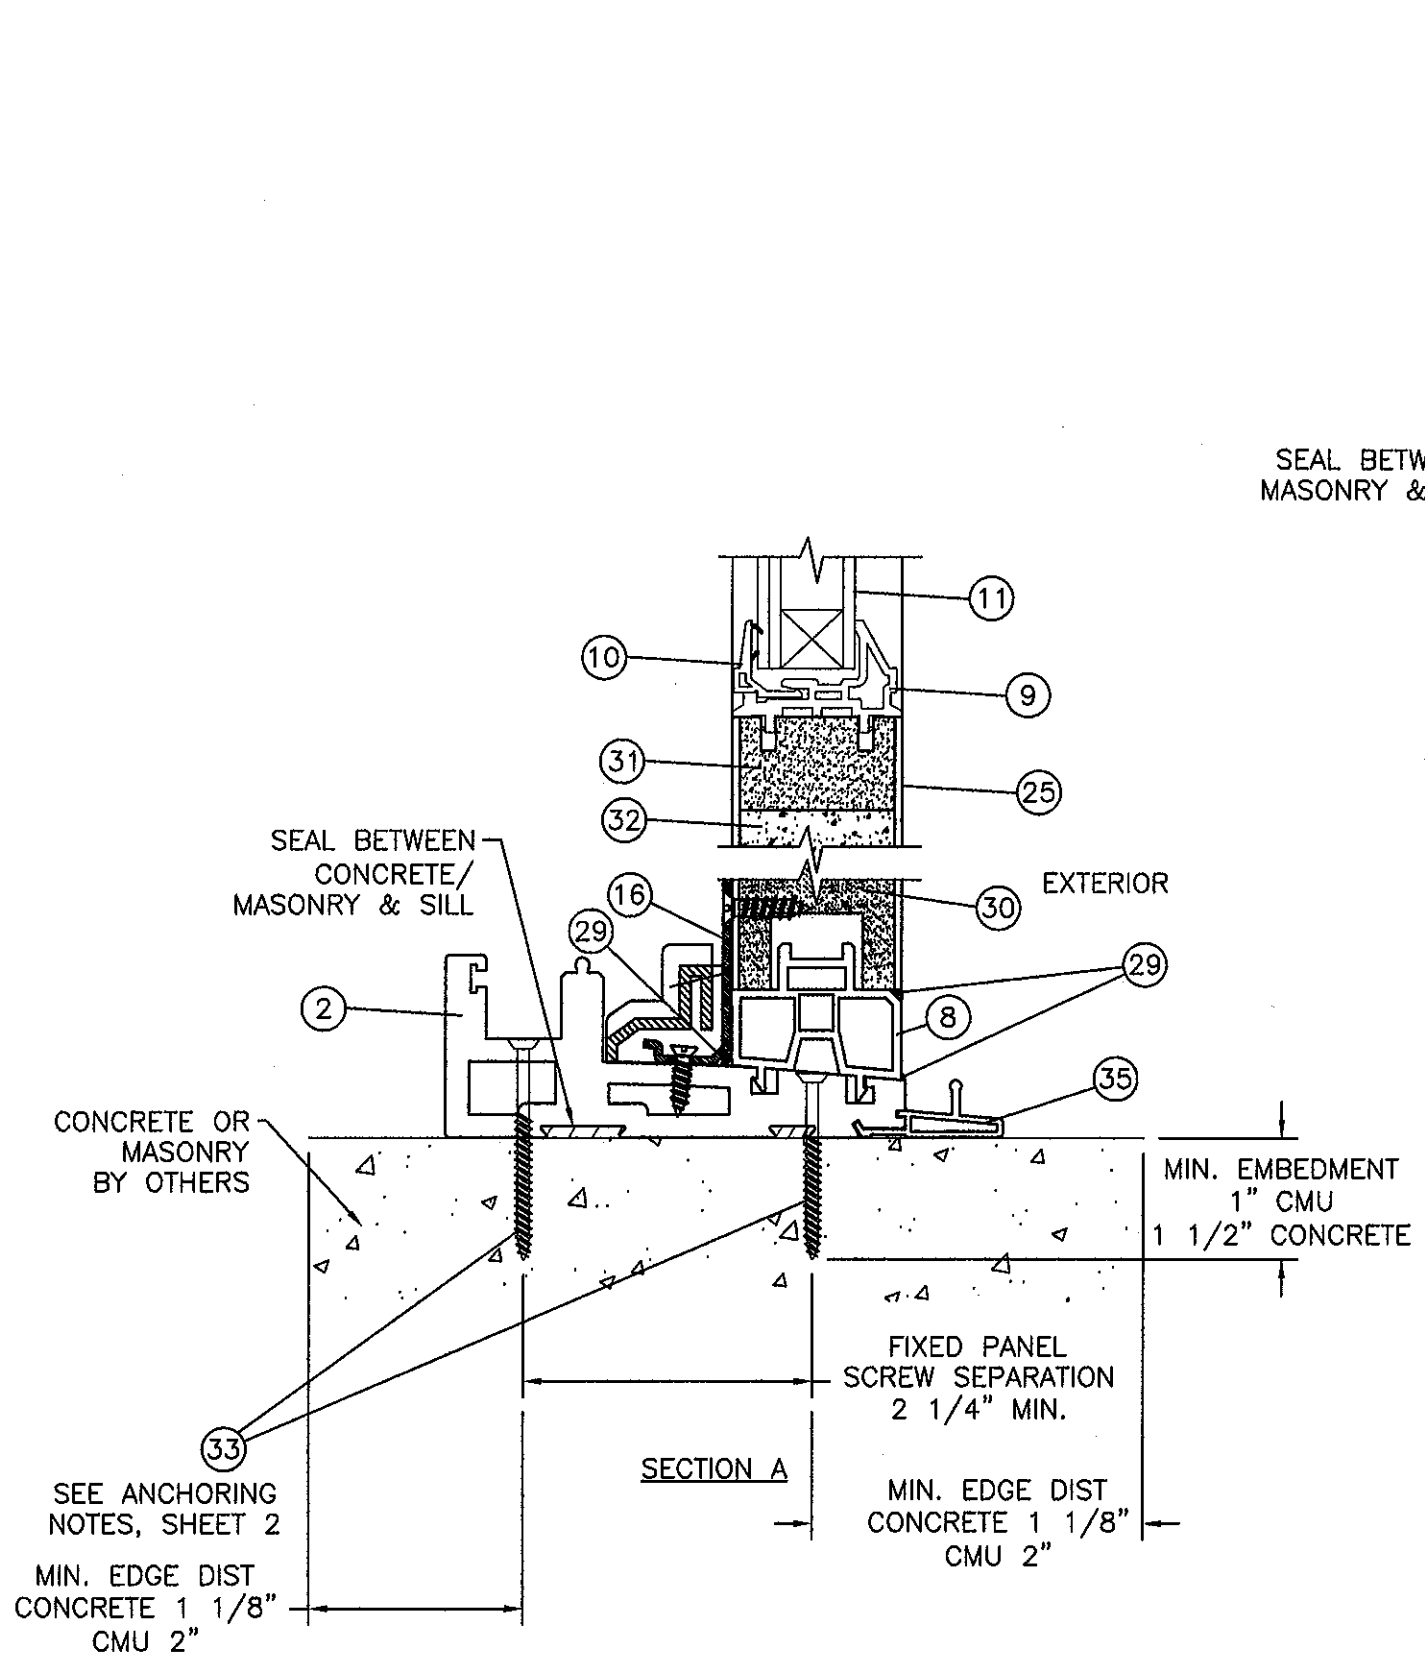

SECTION B
FIXED PANEL SHOWN

PRODUCT REVISED
 in compliance with the Florida
 Building Code
 Amendment No. 11-0415.04
 Registration Date: Aug. 03, 2016
Charles J. Linn
 Licensed Professional Engineer

D	PER DADE LETTER DATED MAY 17, 2011	07/08/11	TJH
C	UPDATED TO 2007 FBC	02/28/11	JM
B	PER DADE COUNTY LETTER DATED	08/20/08	DRL
SYM	REVISION	DATE	BY

PTC PRODUCT DESIGN GROUP, LLC
 PO BOX 520775
 LONGWOOD, FL 32752
 FBPE CERTIFICATE OF AUTHORIZATION NO. 25935



Robert J. Amoroso P.E.
 FL No. 49752

NAN YA PLASTICS CORPORATION
 8909 NORTH LOOP EAST, HOUSTON TX. 77029

TITLE: 8' FIBERGLASS GLIDING PATIO DOOR (OXO)
 VERTICAL CROSS SECTIONS

PREPARED BY: **PTC**
 PTC PRODUCT DESIGN GROUP, LLC
 Phone 321-690-1788 Fax 321-690-1789

DRN: DRL	DATE: 08/29/05
SCALE: N.T.S.	DWG. NO: NAYT0001
REV: D	SHEET: 3 OF 7

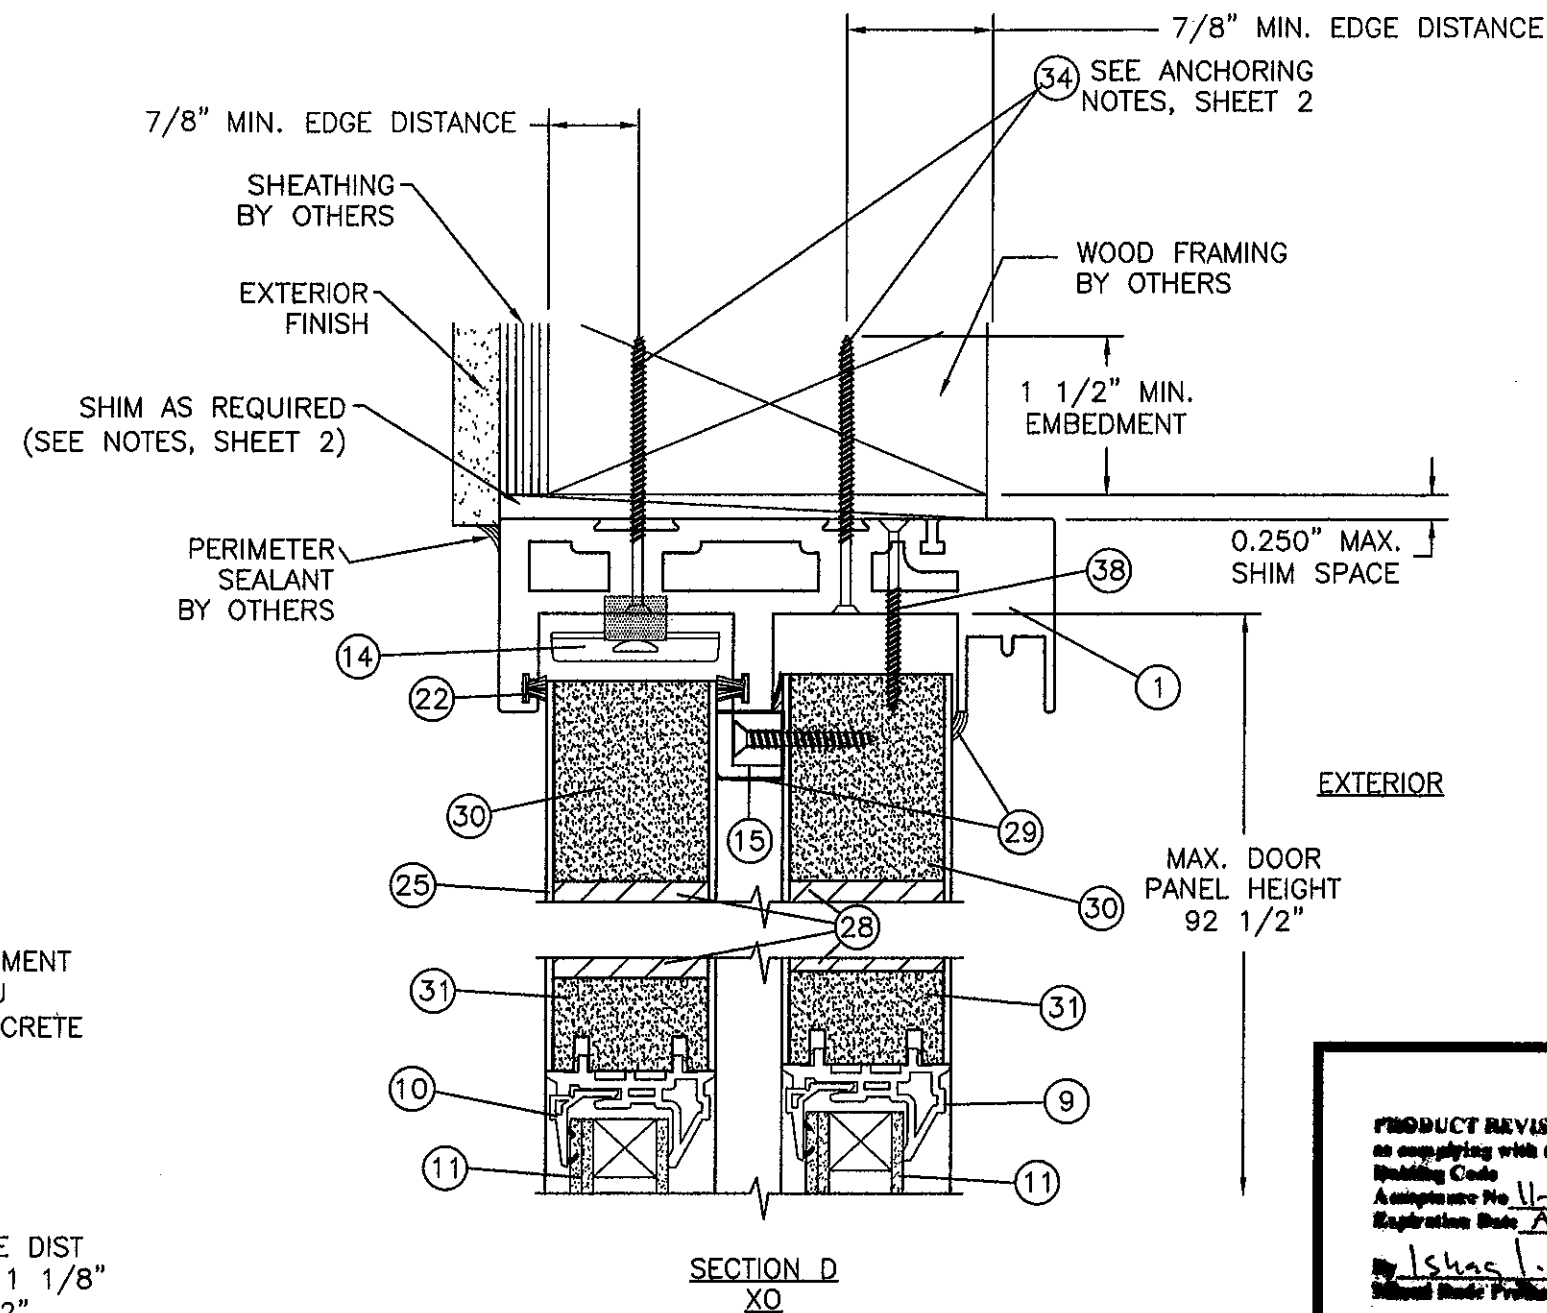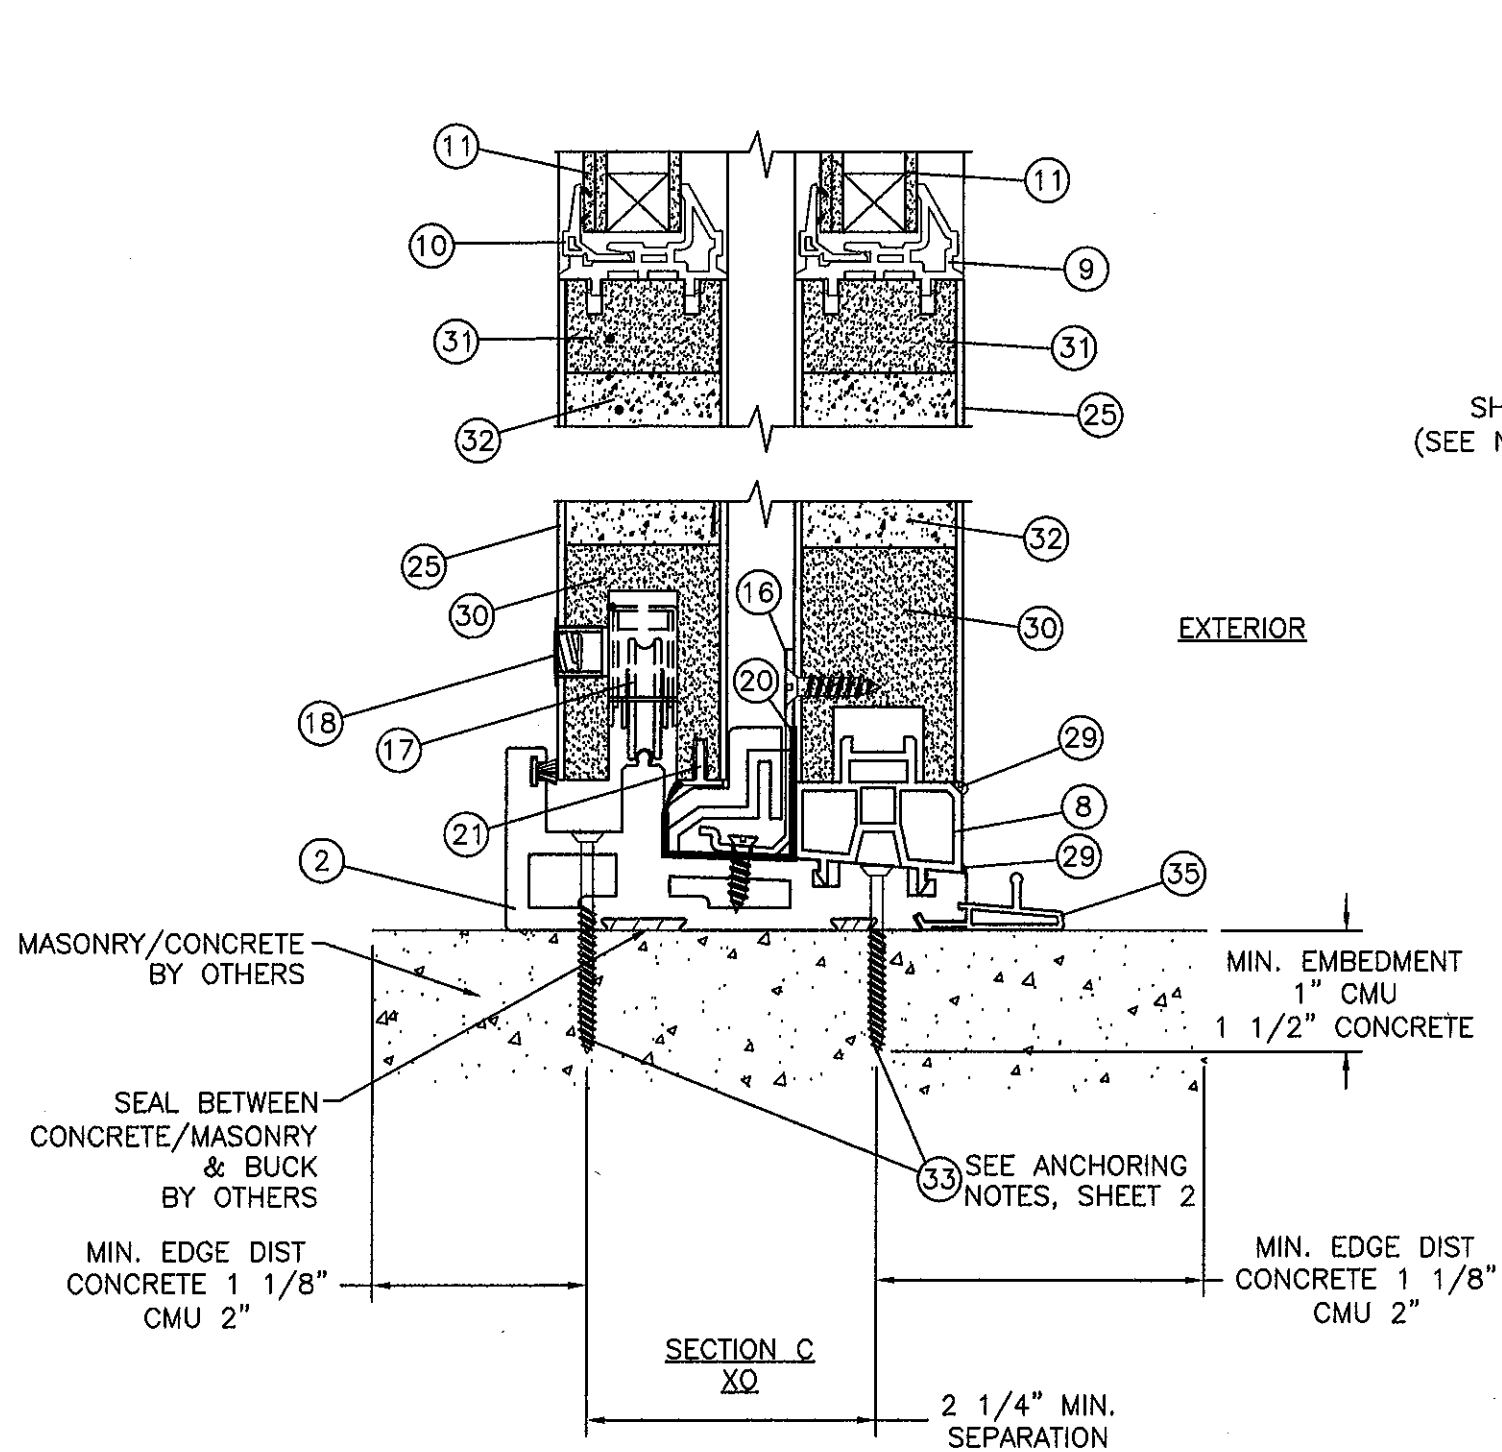

PRODUCT REVISED
to comply with the Florida
Building Code
Amendment No. 11-0415.04
Expiration Date: 08/29/16
By: *Isaac L. L. L.*
Shaded State Product Control

D	PER DADE LETTER DATED MAY 17, 2011	07/08/11	TJH
C	UPDATED TO 2007 FBC	02/28/11	JM
B	PER DADE COUNTY LETTER DATED	08/20/08	DRL
SYM	REVISION	DATE	BY

PTC PRODUCT DESIGN
GROUP, LLC
PO BOX 520775
LONGWOOD, FL 32752
FBPE CERTIFICATE OF
AUTHORIZATION NO. 25935

Robert J. Ambruso, P.E.
FL No. 49752

NAN YA PLASTICS CORPORATION
8909 NORTH LOOP EAST, HOUSTON TX. 77029

TITLE: 8' FIBERGLASS GLIDING PATIO DOOR (OXO)
VERTICAL CROSS SECTIONS

PREPARED BY:

PTC
PTC PRODUCT DESIGN GROUP, LLC

Phone 321-690-1788 Fax 321-690-1789

DRN:

DRL

SCALE:

N.T.S.

REV:

D

DATE:


08/29/05

DWG. NO:

NAYT0001

SHEET:

4 OF 7

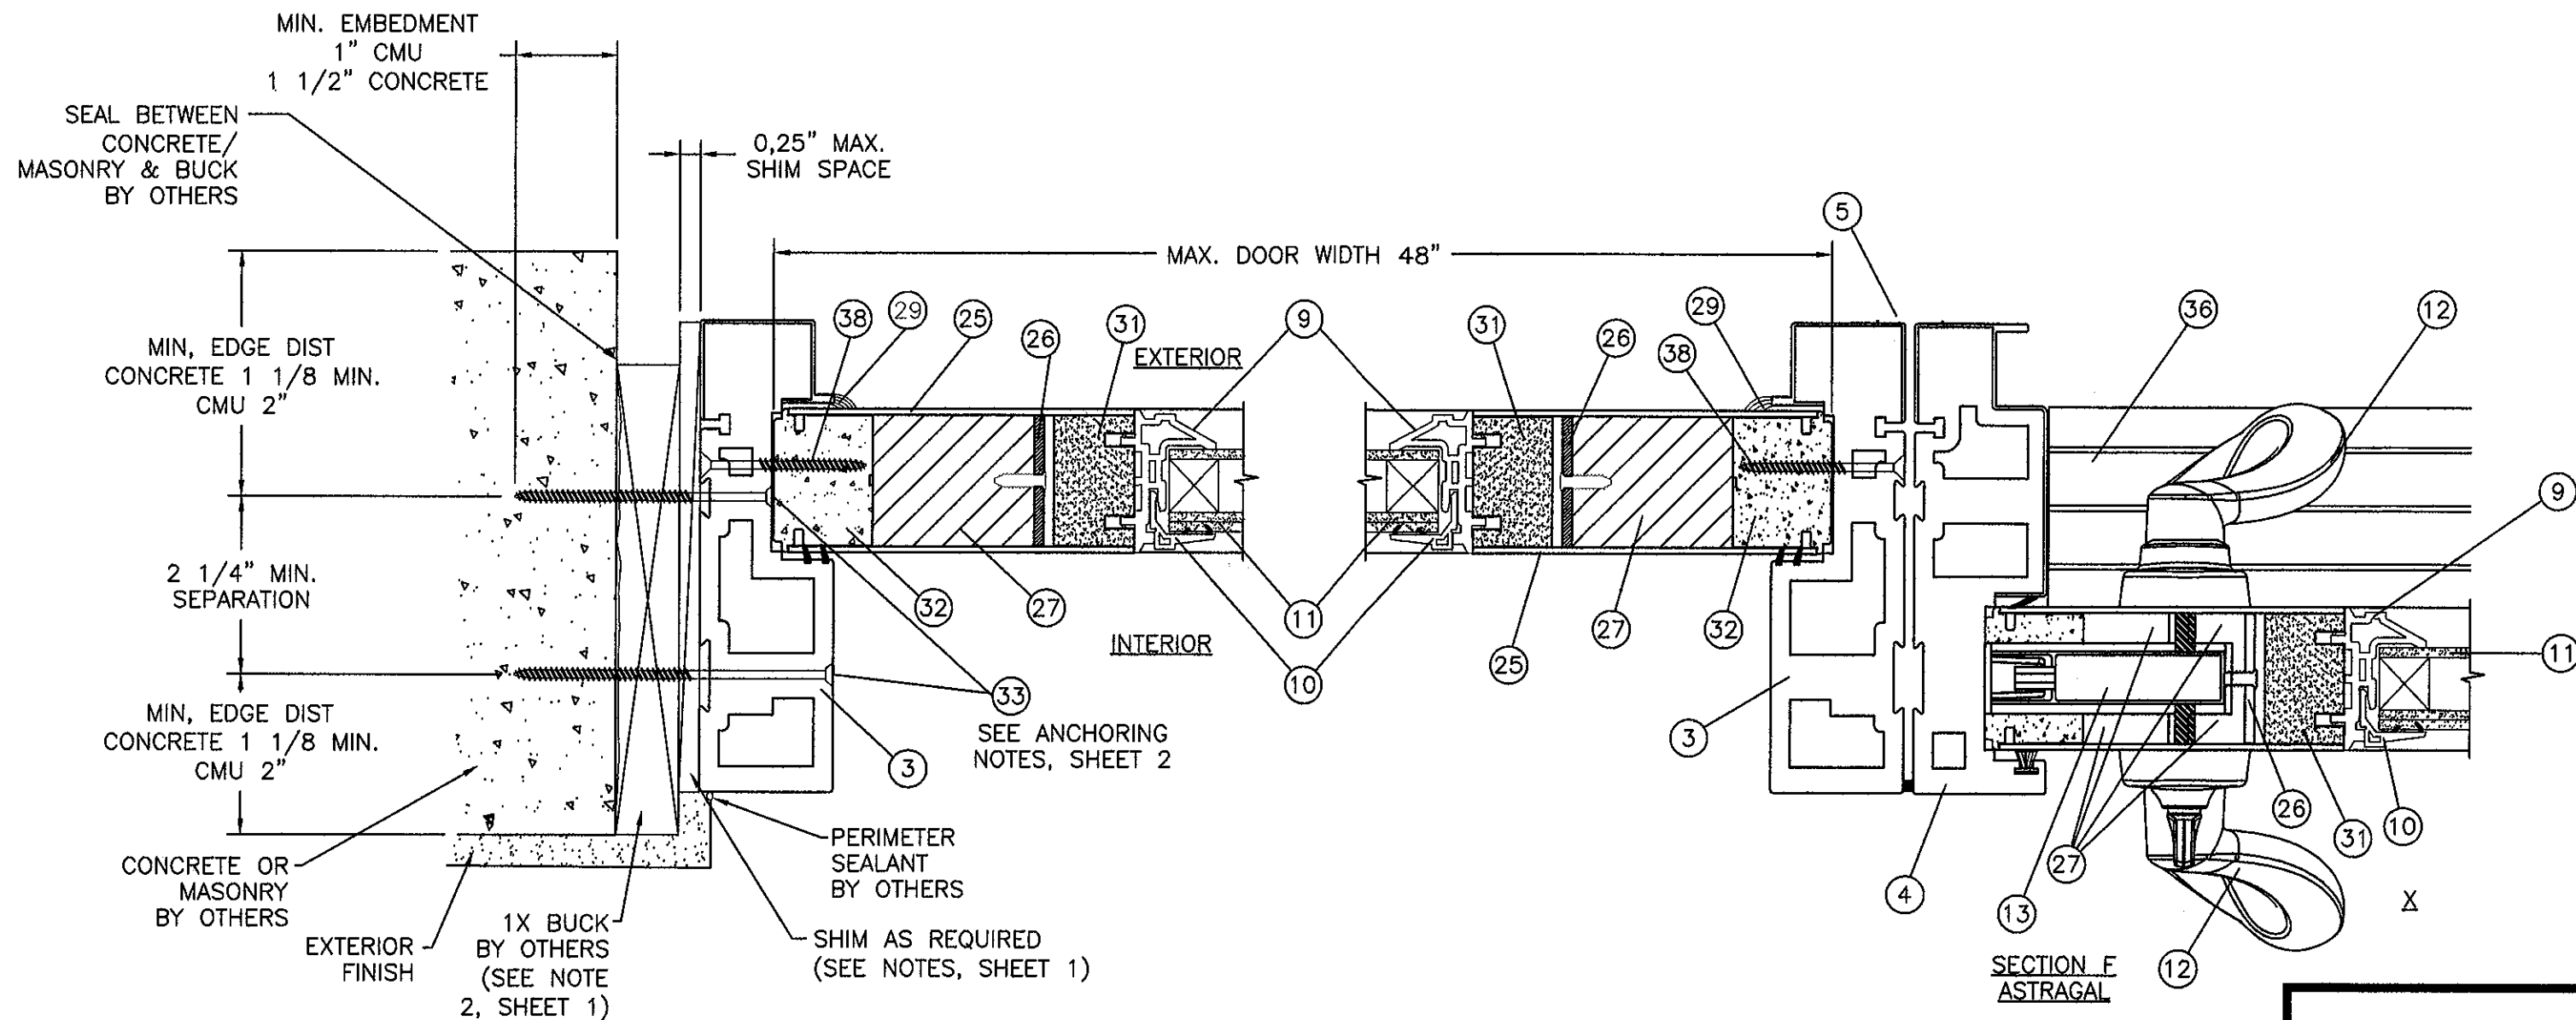

SECTION E

SECTION F
ASTRAGAL

PRODUCT REVISED
to comply with the Florida
Building Code
Acceptance No. 11-0415.04
Expiration Date AUG 03, 2016
By: [Signature]
Product Control

D	PER DADE LETTER DATED MAY 17, 2011	07/08/11	TJH
C	UPDATED TO 2007 FBC	02/28/11	JM
B	PER DADE COUNTY LETTER DATED	08/20/08	DRL
SYM	REVISION	DATE	BY


PTC PRODUCT DESIGN
GROUP, LLC
PO BOX 520775
LONGWOOD, FL 32752
FBPE CERTIFICATE OF
AUTHORIZATION NO. 25935

Robert J. Amoroso P.E.
FL No. 49752

NAN YA PLASTICS CORPORATION
8909 NORTH LOOP EAST, HOUSTON TX. 77029

TITLE: 8' FIBERGLASS GLIDING PATIO DOOR (OXO)
HORIZONTAL CROSS SECTIONS

PREPARED BY: PTC PTC PRODUCT DESIGN GROUP, LLC	DRN: DRL	DATE: 08/29/05
Phone 321-690-1788 Fax 321-690-1789	SCALE: N.T.S.	DWG. NO.: NAYT0001
	REV: D	SHEET: 5 OF 7

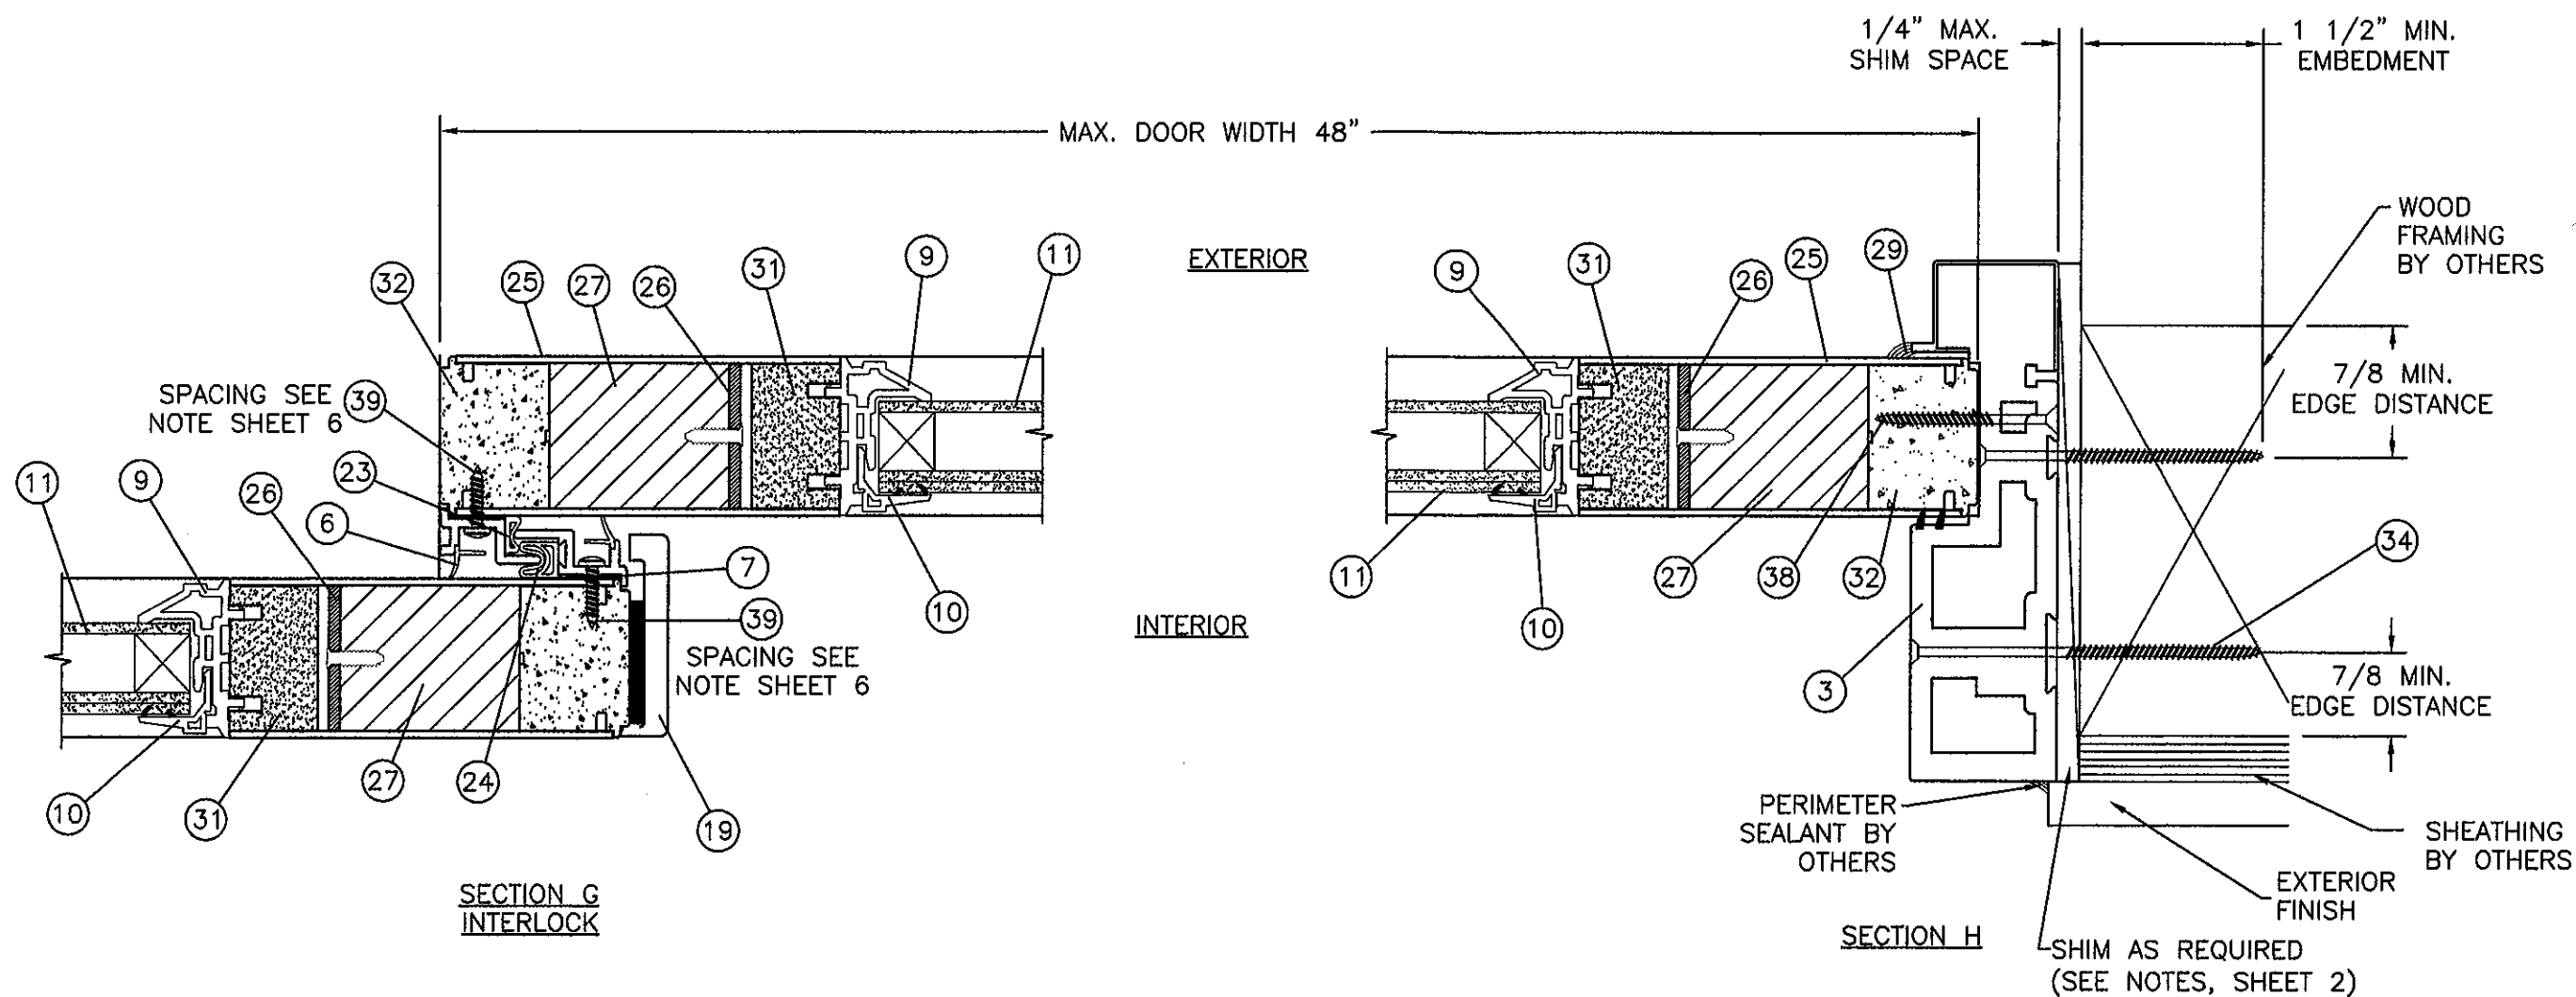

INTERLOCK ATTACHMENT SCREW:
 THE #8 x 1" PPH SCREW ATTACHING THE INTERLOCK
 TO THE FACE OF THE DOOR PANEL IS SPACED 2 3/8"
 FROM THE TOP OF THE PANEL DOWN. THE NEXT SCREW
 IS 7 7/8" DOWN. SCREWS ARE SPACED 9 7/16" THEREAFTER.
 THE BOTTOM SCREW IS SPACED 1 3/4" UP FROM THE
 BOTTOM OF THE DOOR PANEL.

PRODUCT REVISED
 in complying with the Florida
 Building Code
 Amendment No. 11-0415.04
 Adoption Date 06/03/2016
 By: [Signature]
 Product Control

d	PER DADE LETTER DATED MAY 17, 2011	07/08/11	TJH
c	UPDATED TO 2007 FBC	02/28/11	JM
b	PER DADE COUNTY LETTER DATED	06/20/08	DRL
SYM	REVISION	DATE	BY

PTC PRODUCT DESIGN
 GROUP, LLC
 PO BOX 520775
 LONGWOOD, FL 32752
 FBPE CERTIFICATE OF
 AUTHORIZATION NO. 25935

Robert J. Amoroso, P.E.
 Notary Public
 Notary Seal: Robert J. Amoroso, P.E., Notary Public, State of Florida, Commission Expires 12/31/2011










NAN YA PLASTICS CORPORATION
 8909 NORTH LOOP EAST, HOUSTON TX. 77029

TITLE: 8' FIBERGLASS GLIDING PATIO DOOR (OXO)
 HORIZONTAL CROSS SECTIONS

PREPARED BY:	DRL	DATE:	08/29/05
SCALE:	N.T.S.	DWG. NO.:	NAYT0001
REV:	D	SHEET:	6 OF 7

PTC PRODUCT DESIGN GROUP, LLC
 Phone 321-690-1788 Fax 321-690-1789

BILL OF MATERIAL				
ITEM #	PART #	DESCRIPTION	VENDOR	
1	PS711	FRAME HEAD	CELLULAR PVC FTU = 6,019 PSI	NAN YA PLASTICS
2	PS713	FRAME SILL	CELLULAR PVC FTU = 6,019 PSI	NAN YA PLASTICS
3	PS715	FRAME FIXED JAMB	CELLULAR PVC FTU = 6,019 PSI	NAN YA PLASTICS
4	PS714	FRAME JAMB	CELLULAR PVC FTU = 6,019 PSI	NAN YA PLASTICS
5	SA105	ALUMINUM MULLION	6063-T5	NAN YA PLASTICS
6	PS744	INTERLOCK STRIP	RIGID PVC FTU = 6,140 PSI	NAN YA PLASTICS
7	PS745	INTERLOCK STRIP	RIGID PVC FTU = 6,140 PSI	NAN YA PLASTICS
8	PS751	FIXED PANEL BASE	RIGID PVC FTU = 6,140 PSI	NAN YA PLASTICS
9	PAS7N	GLAZING BEAD	RIGID PVC FTU = 6,140 PSI	NAN YA PLASTICS
10	PAS04	GLAZING BEAD	RIGID PVC FTU = 6,140 PSI	NAN YA PLASTICS
11		1" O.A. INSULATED LAMINATED GLASS (SEE DETAIL)		CARDINAL GLASS INC.
12	SS725	HANDLE SET 5 3/8"		TIFFANY OR ROYAL
13	SS730	SINGLE POINT LOCK SET (STEEL)		TIFFANY OR ROYAL
14	SS716	ANTI-LIFT BLOCK	DIE CASTING	JIUH-CHUAN LOCK CO
15	SS712	TOP WIND STOPPER, EPDM FOAM		NAN YA PLASTICS
16	SS723	FIXED PLATE, STAINLESS STEEL		JIUH-CHUAN LOCK CO
17	SS734	TANDEM ROLLER, STAINLESS STEEL		JAM-YUAN CO.
18	MS702	ADJUSTABLE ROLLER COVER, ABS		NAN YA PLASTICS
19	PS792	STILE CAP	CELLULAR PVC	NAN YA PLASTICS
20	MS713	BOTTOM WIND STOPPER, EPDM FOAM		NAN YA PLASTICS
21	PS045	WEATHERSTRIP	RIGID PVC FTU = 6,140 PSI	NAN YA PLASTICS
22	S7A62	FIN WEATHERSTRIP PILE	RIGID PVC FTU = 6,140 PSI	TIN FU YI
23	SS713	WEATHERSTRIP, EPDM FOAM		SAN SHI
24	SS715	WEATHERSTRIP, EPDM FOAM		SAN SHI
25	1NP40	PANEL SKIN SMC FIBERGLASS FTU = 11.860 PSI tmin=.149"		NAN YA PLASTICS
26		GALVANIZED IRON REINFORCEMENT, 40 X 3T		CSC
27		REINFORCED WOOD, 50 X 40 MM MIN. G = .42		DENG XAV
28		REINFORCED WOOD, 15 X 40 MM MIN. G = .42		DENG XAV
29		995 SILICONE STRUCTURAL SEALANT		DOW CORNING
30	PAS7F	PANEL RAIL	CELLULAR PVC FTU = 6,019 PSI	NA YA PLASTICS
31	PAS74	PANEL RAIL	CELLULAR PVC FTU = 6,019 PSI	NA YA PLASTICS
32	PHENO	PHENOLIC FOAM BOARD		NA YA PLASTICS
33		3/16" DIA. I.T.W. ADVANCED THREADFORM TECH. TAPCON		NOA NO. 09-0121.19
34		#10 X 3" FLATHEAD WOOD SCREW		PURCHASED
35	SA101	ALUMINUM TRACK	6063-T5	DAWEI
36	SA102	ALUMINUM SILL BOARD	6063-T5	DAWEI
37		ALUMINUM SPACER BOX	6063-T5	CARDINAL GLASS INC.
38		#10 X 2 1/2" FLATHEAD WOOD SCREW		PURCHASED
39		#8 X 1" PHILLIPS PANHEAD SCREW		PURCHASED

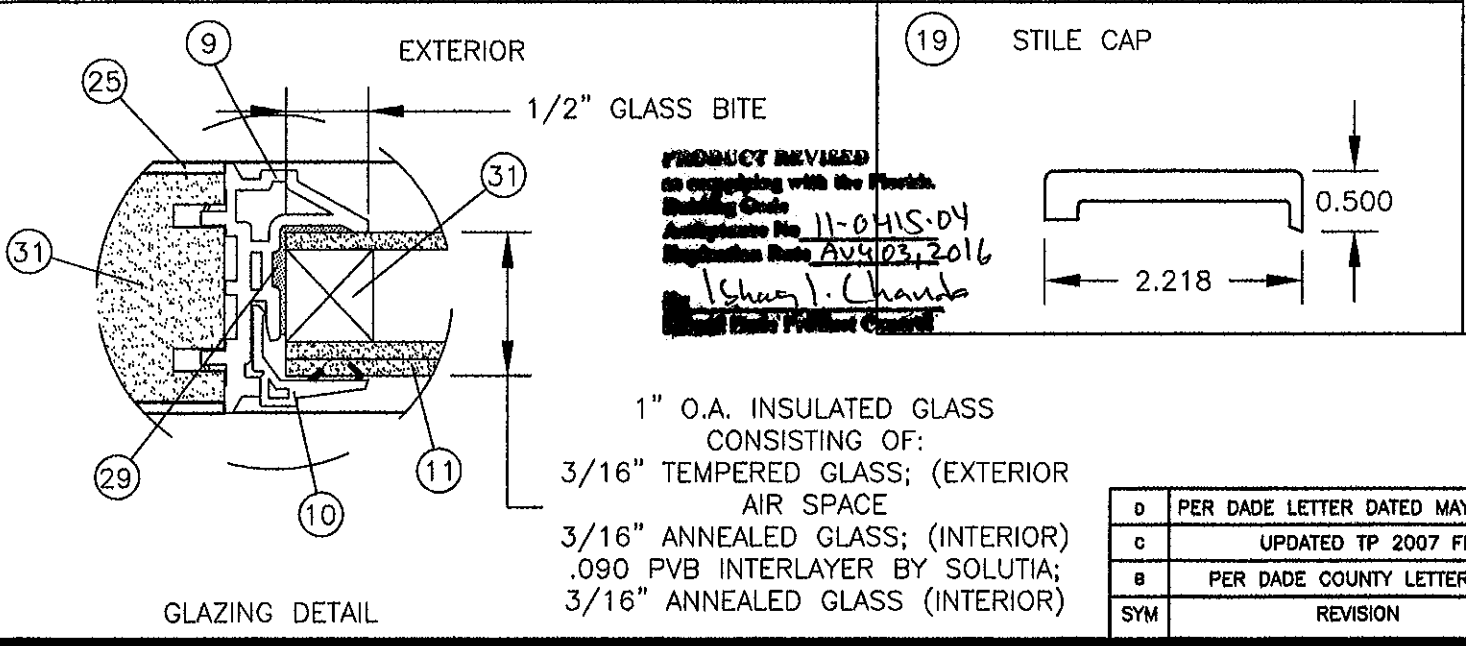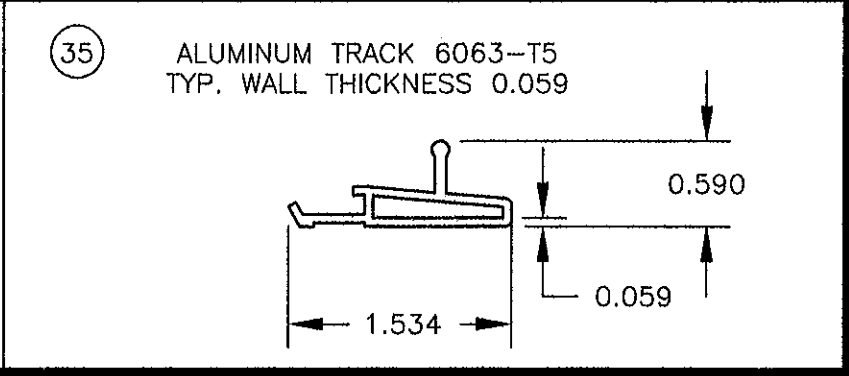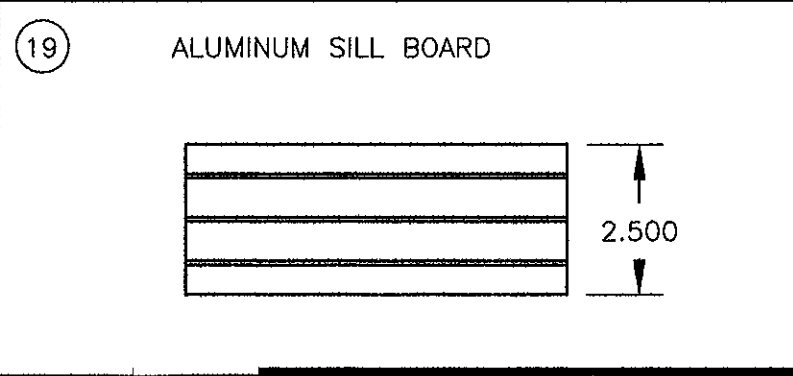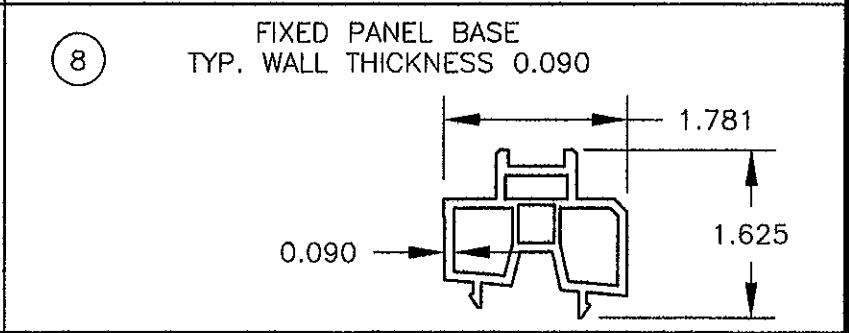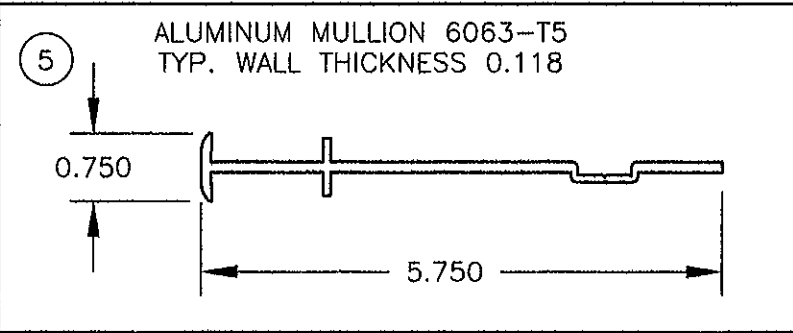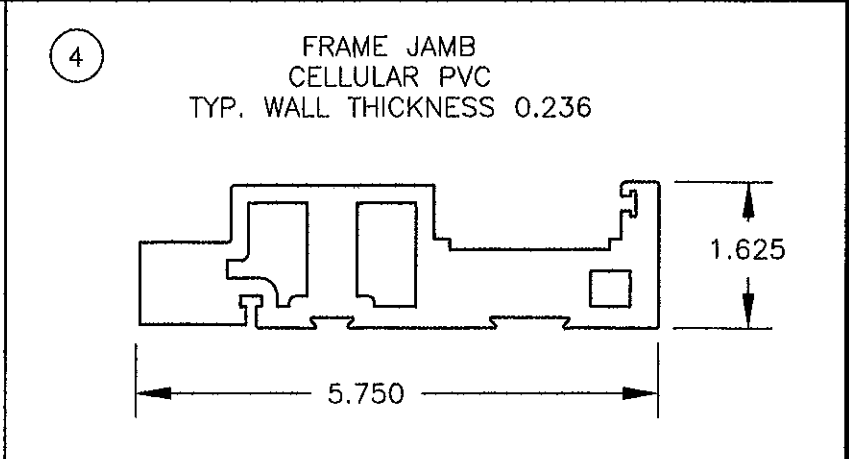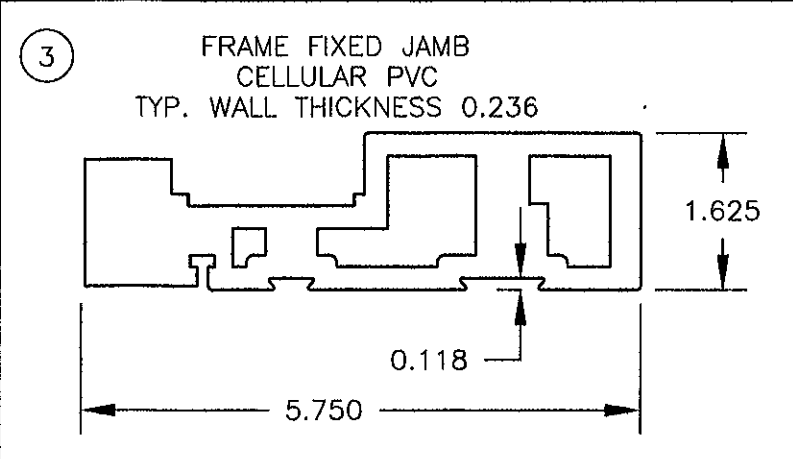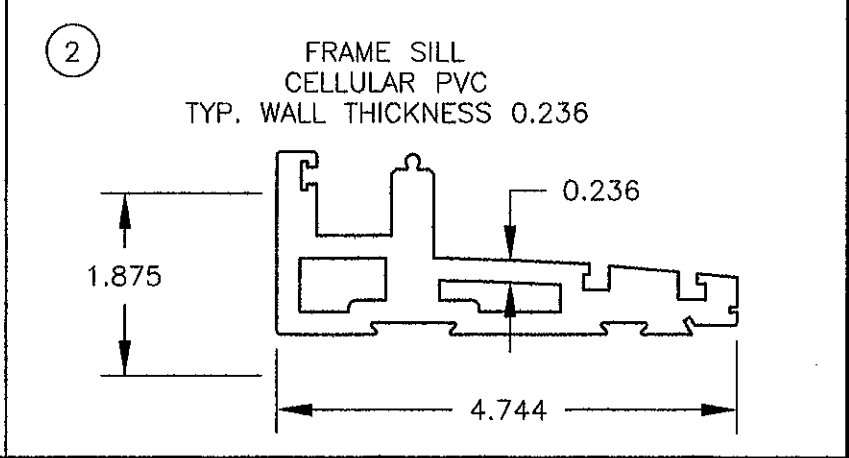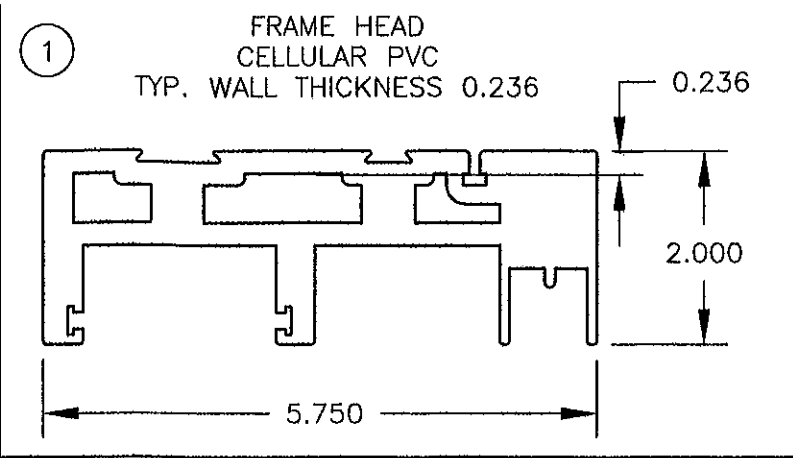

D	PER DADE LETTER DATED MAY 17, 2011	07/08/11	TJH
C	UPDATED TP 2007 FBC	02/28/11	JM
B	PER DADE COUNTY LETTER DATED	08/20/08	DRL
SYM	REVISION	DATE	BY

PTC PRODUCT DESIGN GROUP, LLC
PO BOX 520775
LONGWOOD, FL 32752
FBIPE CERTIFICATE OF AUTHORIZATION NO. 25935

Robert J. Amoruso P.E.
FL No. 49752

7/25/11

NAN YA PLASTICS CORPORATION
8909 NORTH LOOP EAST, HOUSTON TX. 77029

TITLE: 8' FIBERGLASS GLIDING PATIO DOOR (OXO)
BILL OF MATERIALS AND COMPONENTS

PREPARED BY: PTC
PTC PRODUCT DESIGN GROUP, LLC
Phone 321-690-1788 Fax 321-690-1789

DRN: DRL
SCALE: N.T.S.
REV: D

DATE: 08/29/05
DWG. NO: NAYT0001
SHEET: 7 OF 7